


NOTES
 Survey grid and levels are based on Ordnance Survey National Grid, obtained using GPS observations on survey control stations STN1 and STN5. Survey information has been extracted from a point cloud generated by a 3D laser scan survey. Only those elements visible from a safe instrument setup at time of survey are shown. Accuracy ±10mm.
 TruView point cloud viewer is available for this survey. Please contact Bonnington Surveys for details.

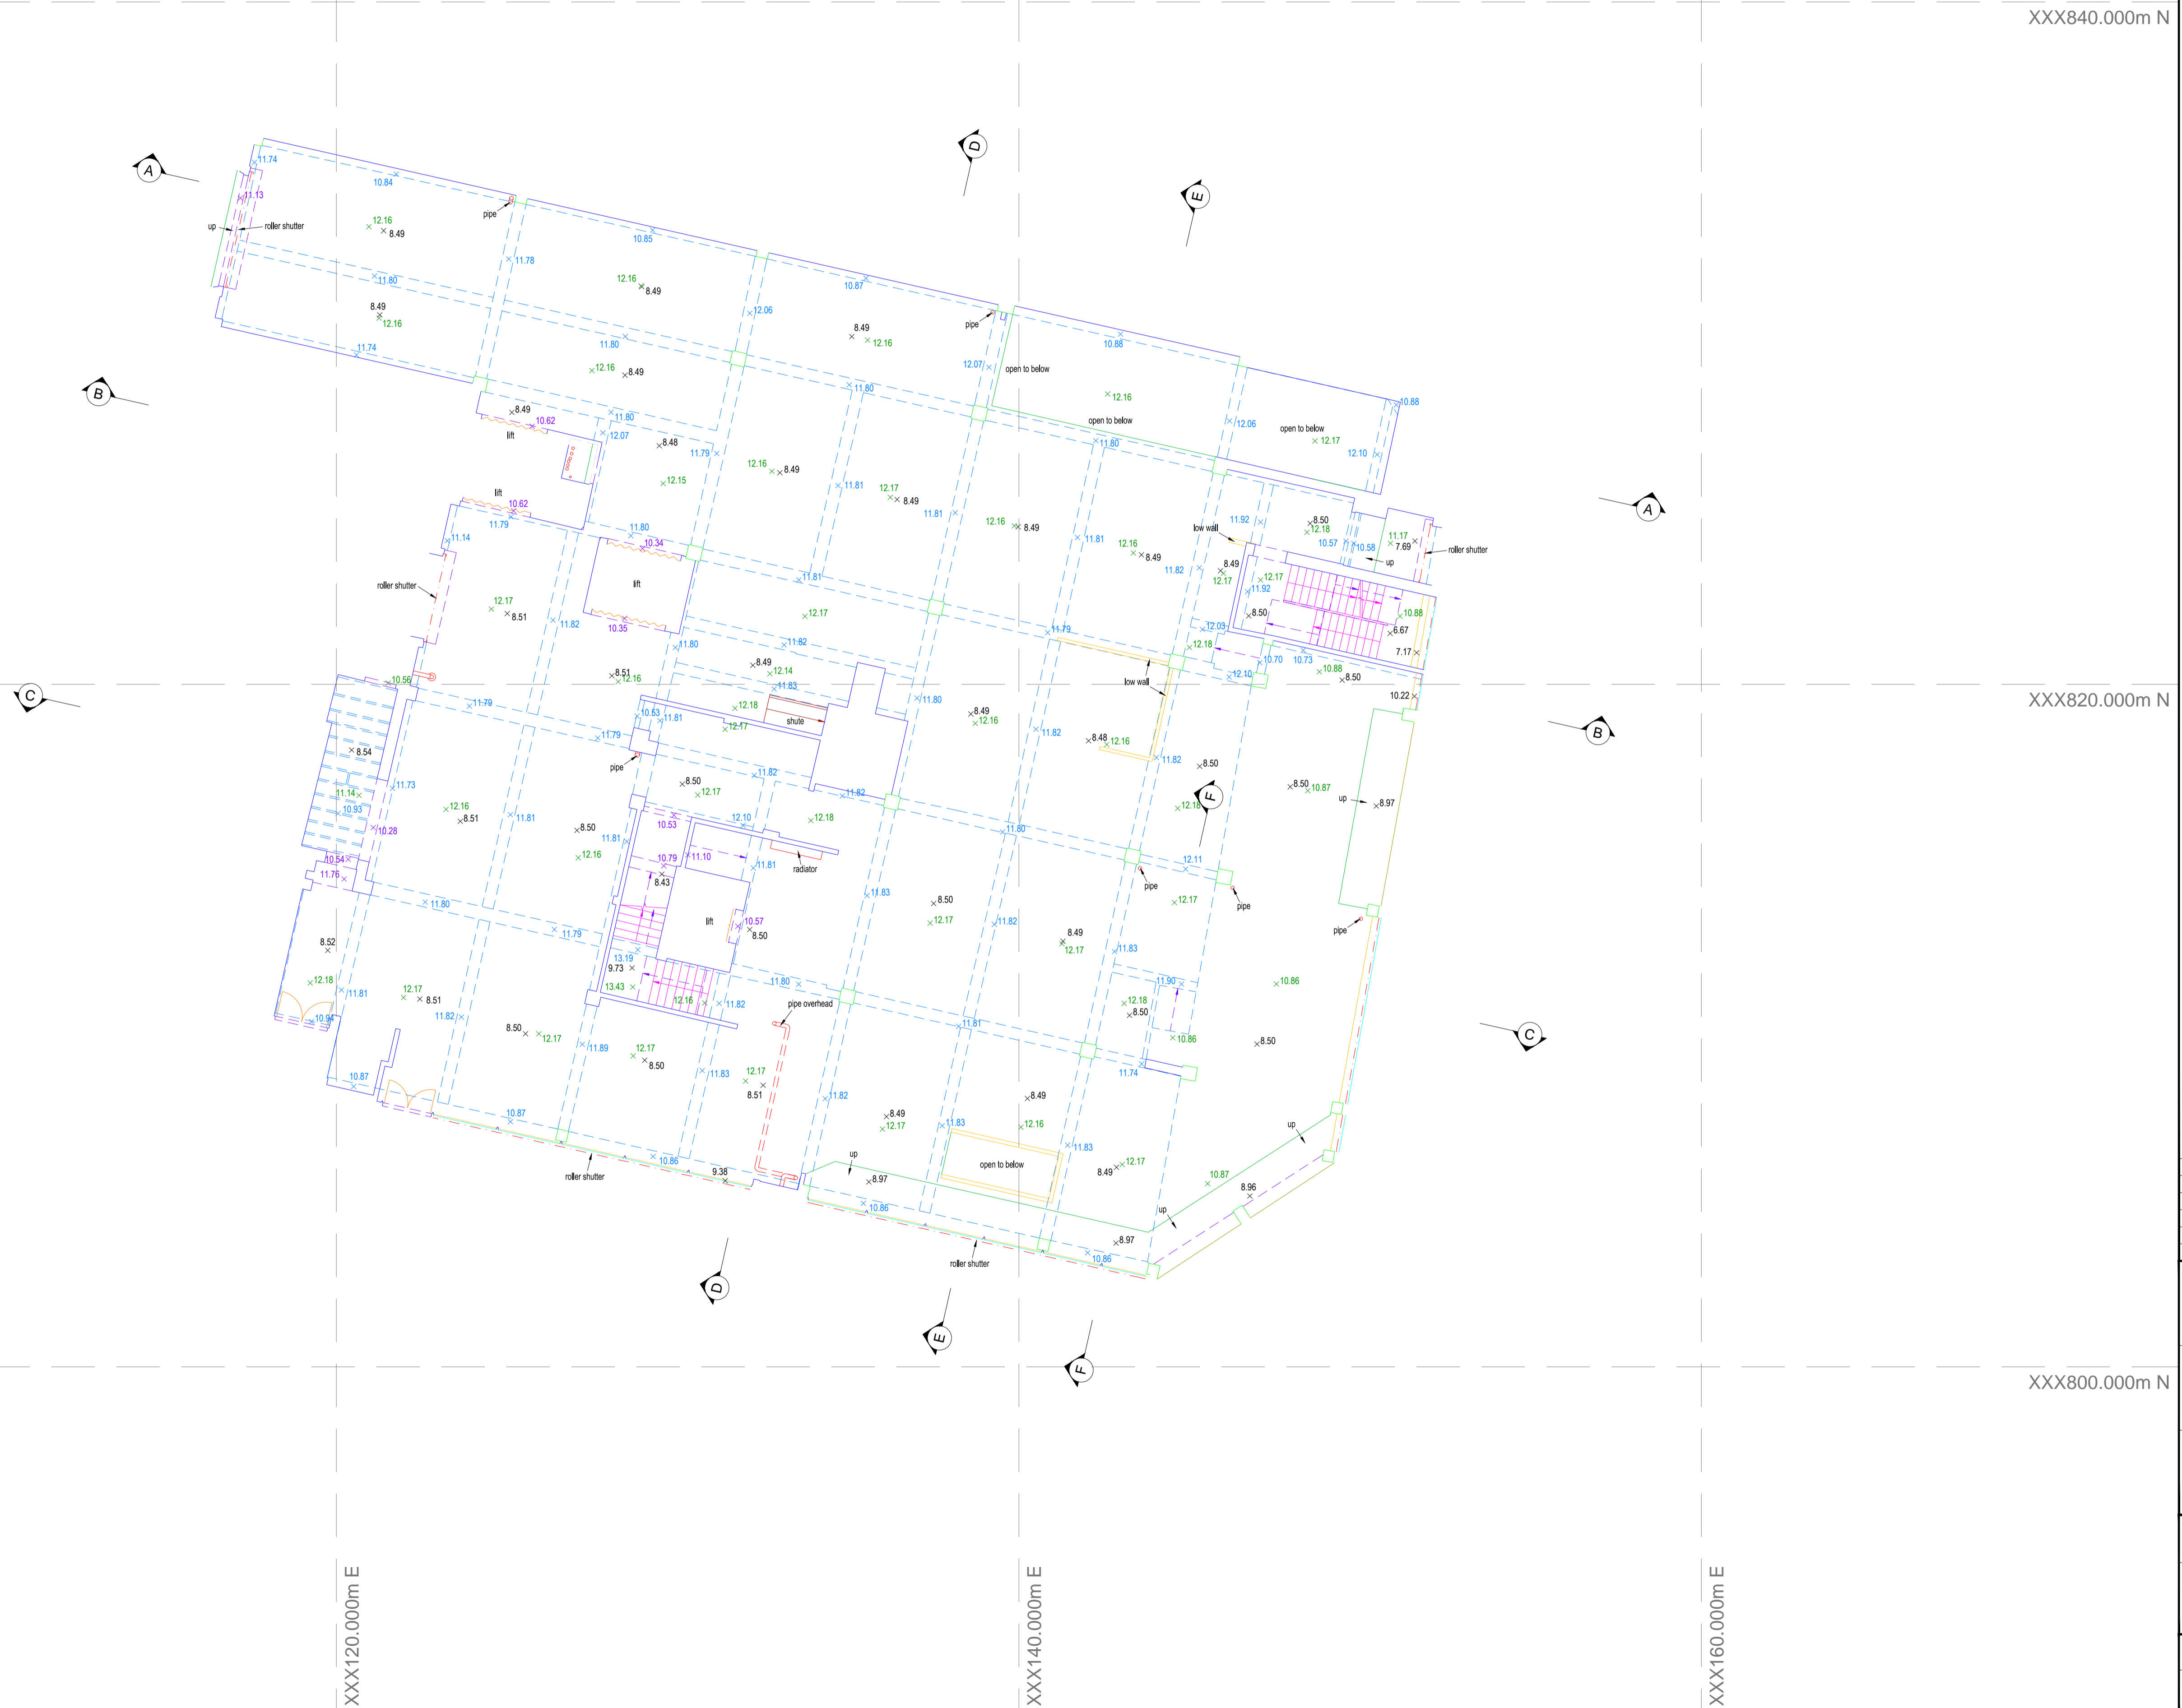

REVISION	DATE	BY	DESCRIPTION
A	27/05/2015	RB	Section tags added

CLIENT

PROJECT NAME

DRAWING TITLE
Sample As-Built Survey

bonnington surveys ltd 
 laser scanning | 3d modelling | bim | surveying | training
 Address Arquen House, 4-6 Spicer St, St Albans, Herts, AL3 4PQ
 Telephone 01727 226221 Website www.bonningtonsurveys.co.uk

DRAWN	CHECKED	DATE	SCALE
RB	LH	July 2015	1:100 @ A1
JOB NO	DRAWING NO	REVISION	
2027	BSL-2027-001	A	